



Level 135, 250 Collins Street  
 Melbourne, VIC 3006  
 E: info@cr-eo.com.au  
 P: 1800 676 676  
 W: www.cr-eo.com.au

This drawing is prepared by CR EO. All rights are reserved. It is to be used for the purpose for which it was prepared and is not to be used for any other purpose without the prior written consent of CR EO. CR EO is not responsible for any errors or omissions in this drawing or for any consequences arising from its use.

The drawings in this drawing are not to be used for construction or for any other purpose without the prior written consent of CR EO. CR EO is not responsible for any errors or omissions in this drawing or for any consequences arising from its use.

Client Approval \_\_\_\_\_ Date \_\_\_\_\_

REV	DATE	NOTES	BY
1	15/07/22	ISSUE FOR PERMIT	CR
2	15/07/22	ISSUE FOR PERMIT	CR
3	17/08/22	ISSUE FOR PERMIT	CR
4	17/08/22	ISSUE FOR PERMIT	CR
5	17/08/22	ISSUE FOR PERMIT	CR
6	17/08/22	ISSUE FOR PERMIT	CR



Client: GPT

Project: LEVEL 135  
 250 COLLINS STREET, MELBOURNE, VIC 3006


Status	Date	Approved
AS BUILT	29/08/22	KC

Drawing Title: FURNITURE PLAN

Job No.	Revision
2156	6

Scale: 1:100 @ A1  
 Drawing No. A210

TO BE READ IN CONJUNCTION WITH SERVICES DRAWINGS

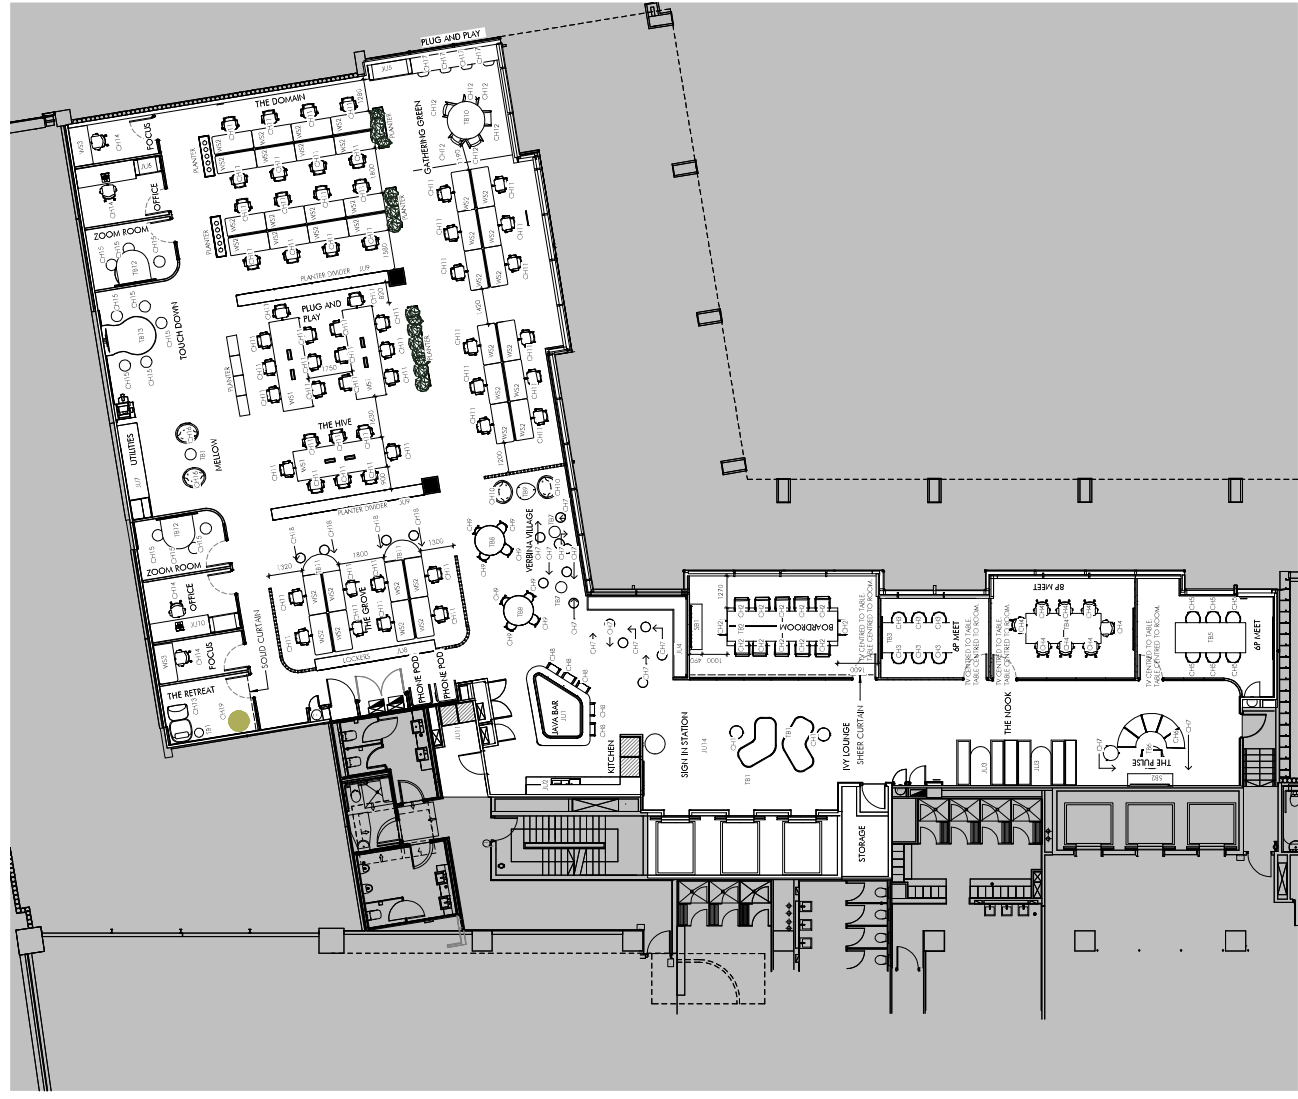

1 FLOOR - FURNITURE PLAN  
 SCALE 1:100